


The Development registered under titles PTH56558 & PTH45215 and plots 6, 13 to 53 & 63 to 73 within have been DPA approved.

The Keeper - 11 November 2024

Keeper for the Registers of Scotland

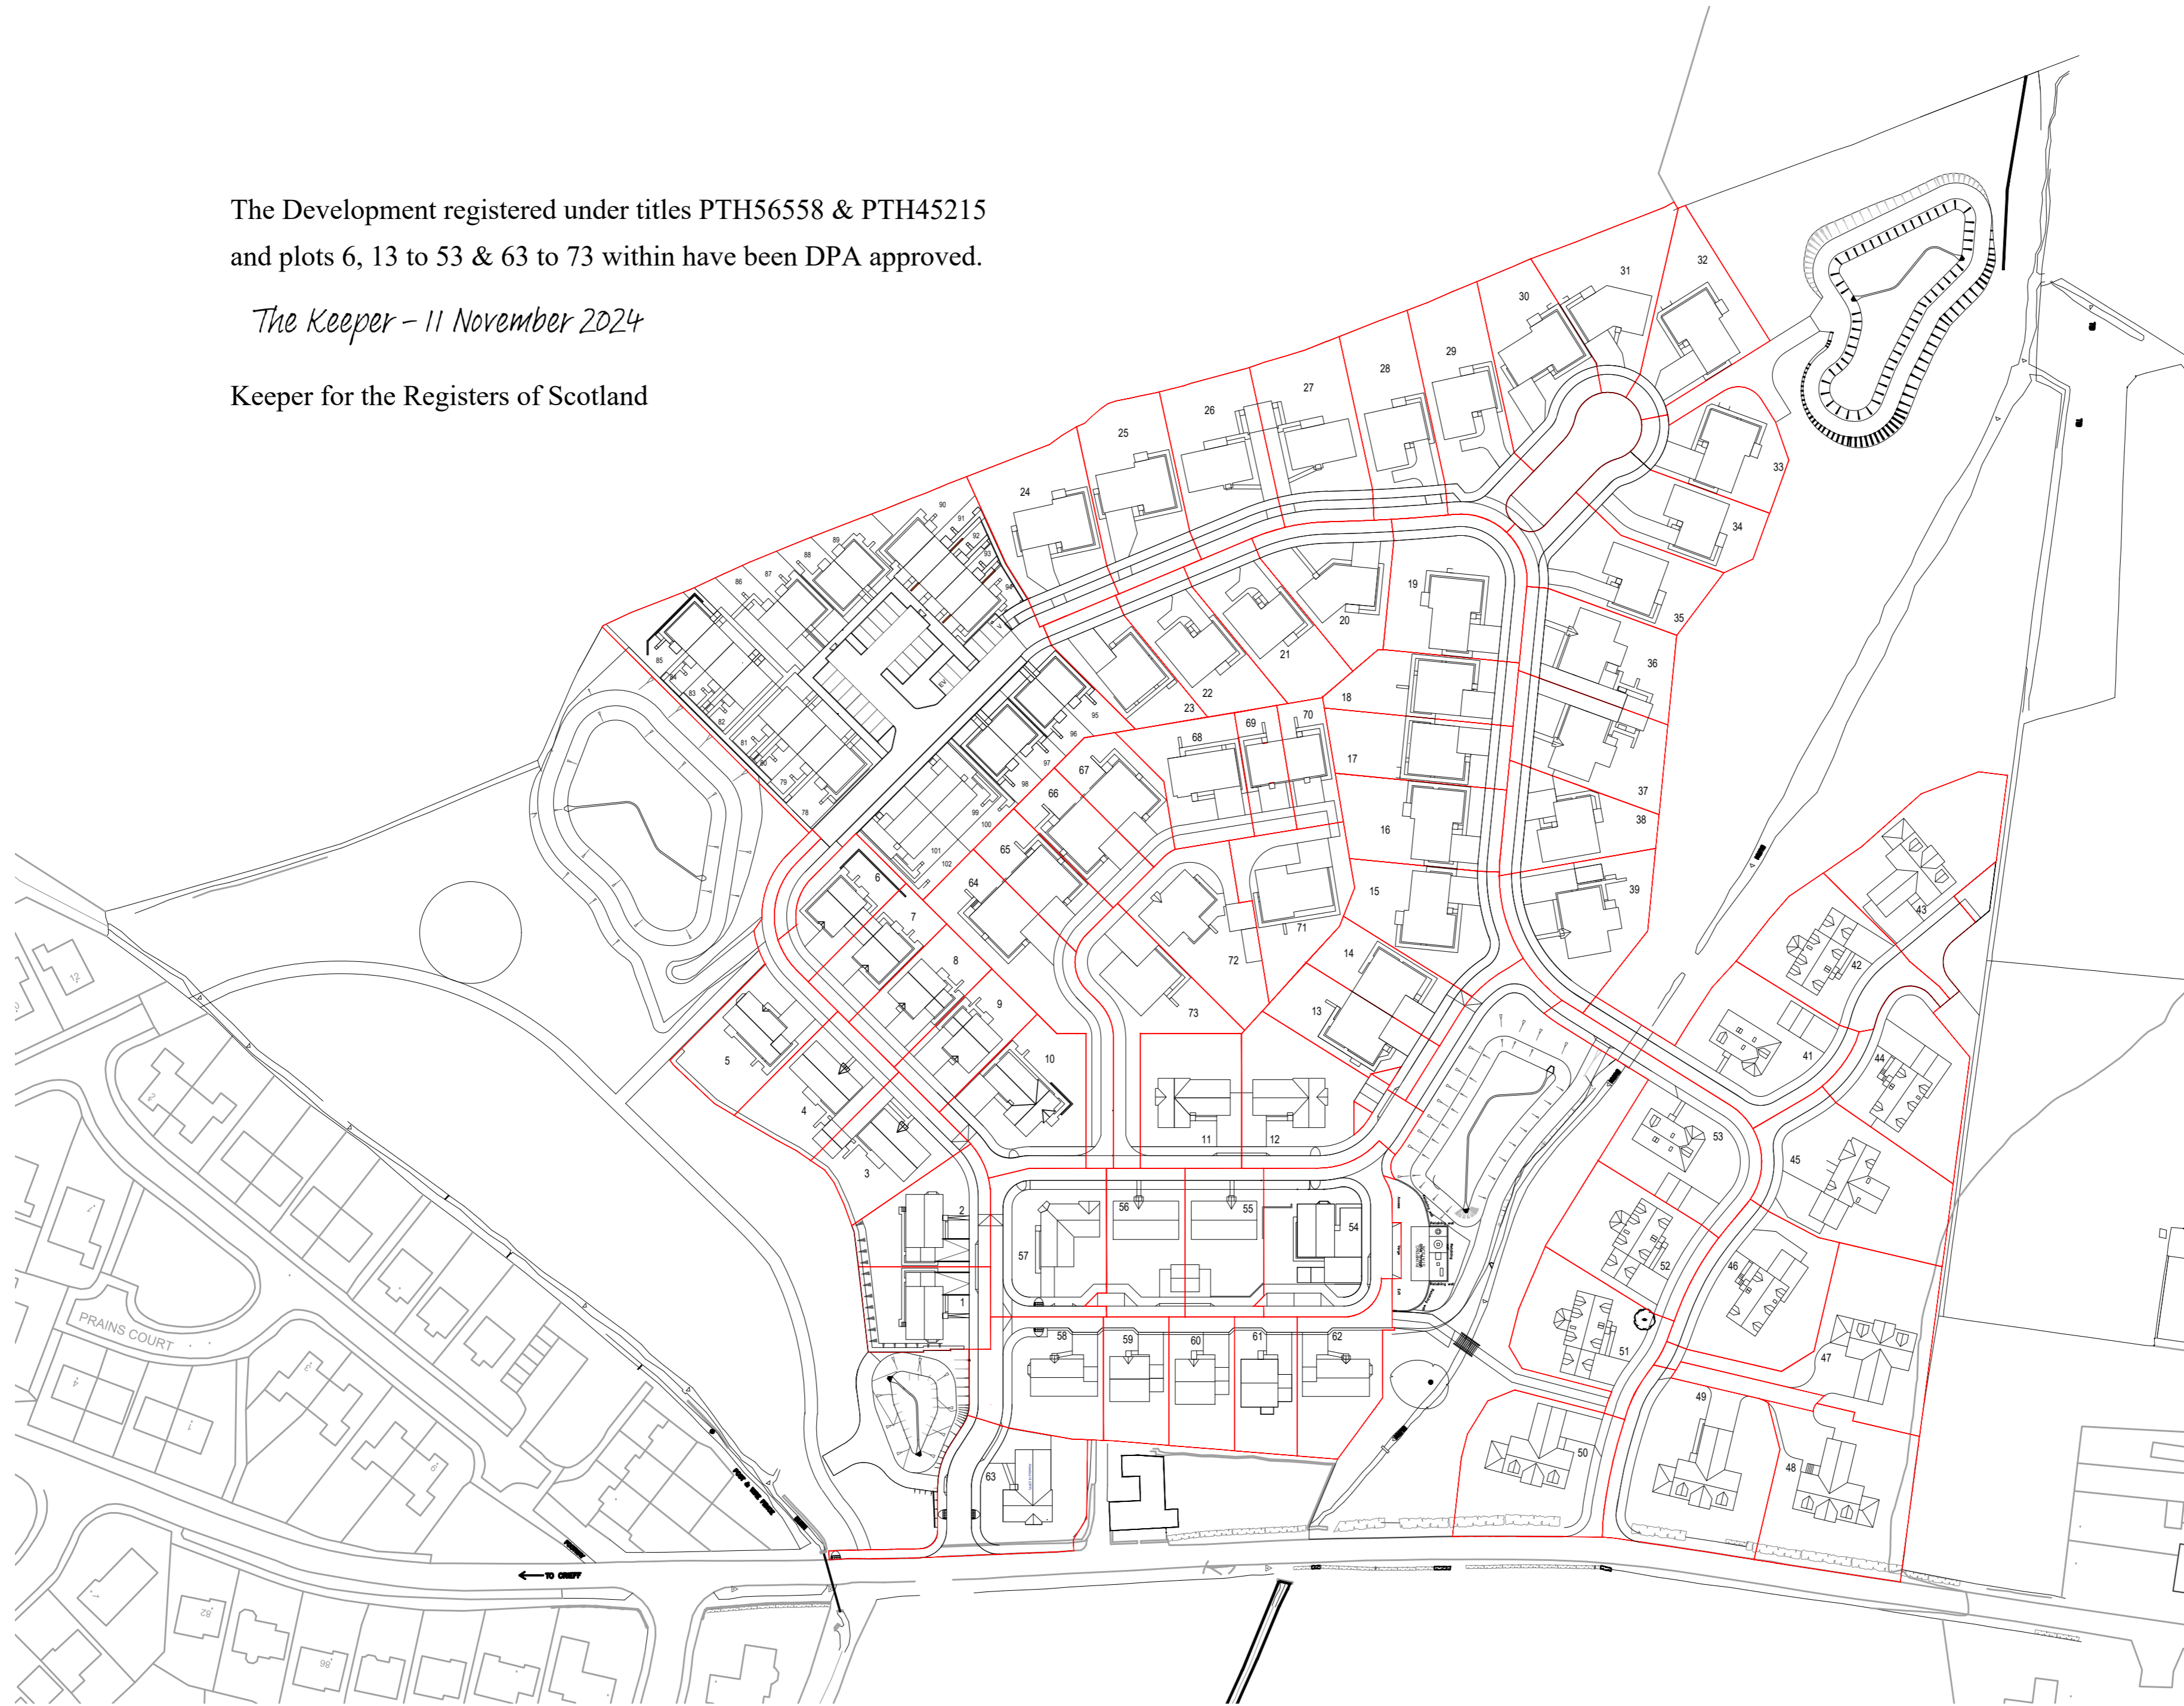

REV	DATE	BY	AMENDMENTS
J	NOV 2024	TF	13-39 & 64-72 UPDATED TO MATCH CONSTRUCTION LAYOUT
I	JAN 2024	TF	78-102 & PLOT 5 BOUNDARY AMENDED TO MATCH APPROVED DPA
H	AUG 2023	CM	ROAD UPDATES AT PLOTS 38,12 AND 28-35
G	JUL 2023	TF	RED LINE TO PLOTS 78-102 REVISED
F	JUL 2023	CM	UPDATES TO PLOTS 13-19, 36-40 & 78-102
E	JAN 2023	TF	PLOTS 3-10 LAYOUT REVISED
D	OCT 2022	TF	OPEN SPACE ADJACENT TO PLOTS 12 & 13 NOW SHOWN
C	OCT 2022	TF	PLOT 1 SOUTHERN BOUNDARY REVISED. BOUNDARY BETWEEN PLOTS 12 & 13 REVISED TO SPLIT DOWN MIDDLE OF ADJACENT PARKING SPACES
B	OCT 2022	TF	BOUNDARY TO NORTH OF PLOTS 24 & 25 AMENDED FOLLOWING COMMENT FROM RGS
A	AUG 2021	KS	AMENDED AS PER MISC CORRESPONDENCE

GS Brown
CONSTRUCTION

The Nurseries,
St Madoes,
Glencarse, PH2 7NF
Tel: 01738 860591
Email: office@gsbrown.co.uk
www.gsbrown.co.uk

J:\10 Live Sites\10 WTC - Tomaknock, Crieff\19. Legal\Superseded\WTC (LE) 100 rev G

DATE:	SCALE:	DRAWN BY:
JULY 2021	1:1000 @ A2	KS
DWG TITLE:		
DPA PLAN		
(FULL SITE)		
PROJECT:		
WESTER TOMAKNOCK, CRIEFF		
DWG No.	WTC (LE) A101	Rev. J

