

NOTES/REVISIONS


REVISION A PROCESSED & VERIFIED BY EW DATE 18.09.23 VALIDATED BY DCS DATE SEPT 23
 Scale changed to 1:1250. Street names added. Service Wayleave removed from phases 2 and 3.
 REVISION B PROCESSED & VERIFIED BY EW DATE 18.09.23 VALIDATED BY DCS DATE SEPT 23
 Scale of services wayleave amended.
 REVISION C PROCESSED & VERIFIED BY EW DATE 21.11.23 VALIDATED BY DCS DATE NOV 23
 Red site boundary amended to exclude open space in front of plots 5-10.
 REVISION D PROCESSED & VERIFIED BY EW DATE 29.04.24 VALIDATED BY GC DATE APR 24
 Small section of 'ROAD (to be factored)' removed from inside the red line of plot 4.

The Development registered under title KNC32772 and plots 1 to 11 and 14 to 18 within have been DPA approved.

The Keeper - 30 April 2024

Keeper for the Registers of Scotland

- SITE BOUNDARY
- INDIVIDUAL PLOT BOUNDARY
- OPEN SPACE (TO BE FACTORED)
- FOOTWAY (TO BE FACTORED)
- ROAD (TO BE FACTORED)
- SHARED - PLOTS 4 & 5 (TO BE FACTORED)
- SHARED - PLOTS 5-10
- SHARED - PLOTS 12 & 13
- SHARED - PLOTS 14-18
- SUB STATION (TO BE ADOPTED)
- SERVICES WAYLEAVE

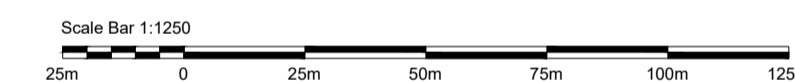

Ordnance Survey material is reproduced with the permission of the controller of Her Majesty's Stationery Office. Crown Copyright reserved. Licence No. AL100014525 - dated 28th December 2003



Muir Homes
 Muir Homes Limited Email: muir@muir-group.co.uk
 Muir House, Belleknowes Indus. Est., Fax No. 01383 411112
 Inverkeithing, Fife KY11 1HF, Scotland Telephone: 01383 416196

PROJECT
GRAZING 1 - BLAIRS VILLAGE
SOUTH DEESIDE ROAD, ABERDEEN

TITLE
DEVELOPMENT PLAN APPROVAL

DRAWN	EW	DATE	22.08.23	SCALES		
VERIFIED	EW	DATE	AUG 23	A1	1:1250	A2 -
VALIDATED	GC	DATE	AUG 23	A3	-	A4 -

DRAWING NO. **1327-DPA** REVISION **D**